

The Otolith Group
La forma del pensament

EE'

A

B

FF'


GG'

Jack Dirby / Lord of Light

Anónim Products: Soviet Agency Delegation

Pastels

1. V. Sagar/ Sterile entity
2. V. Sagar/ Forensic Deposition on the Troposphere of the Visitation
3. V. Sagar/ A sunken Trembling, Recalled Dimly
4. V. Sagar/ Quasi Object Outline
5. V. Sagar/ Orthogon
6. V. Sagar/ The Seventh Side of the Haba Radiant
7. V. Sagar/ The Hidden Face of the Star-Shaped Thing
8. V. Sagar/ Allure a Lure a Part Apart
9. V. Sagar/ That Curious Group of Dots Whose Presence Now Assume a Vastly Larger Significance
10. V. Sagar/ A Single Sight of a Tangible Object Whose Unexpected Property Proved Itself

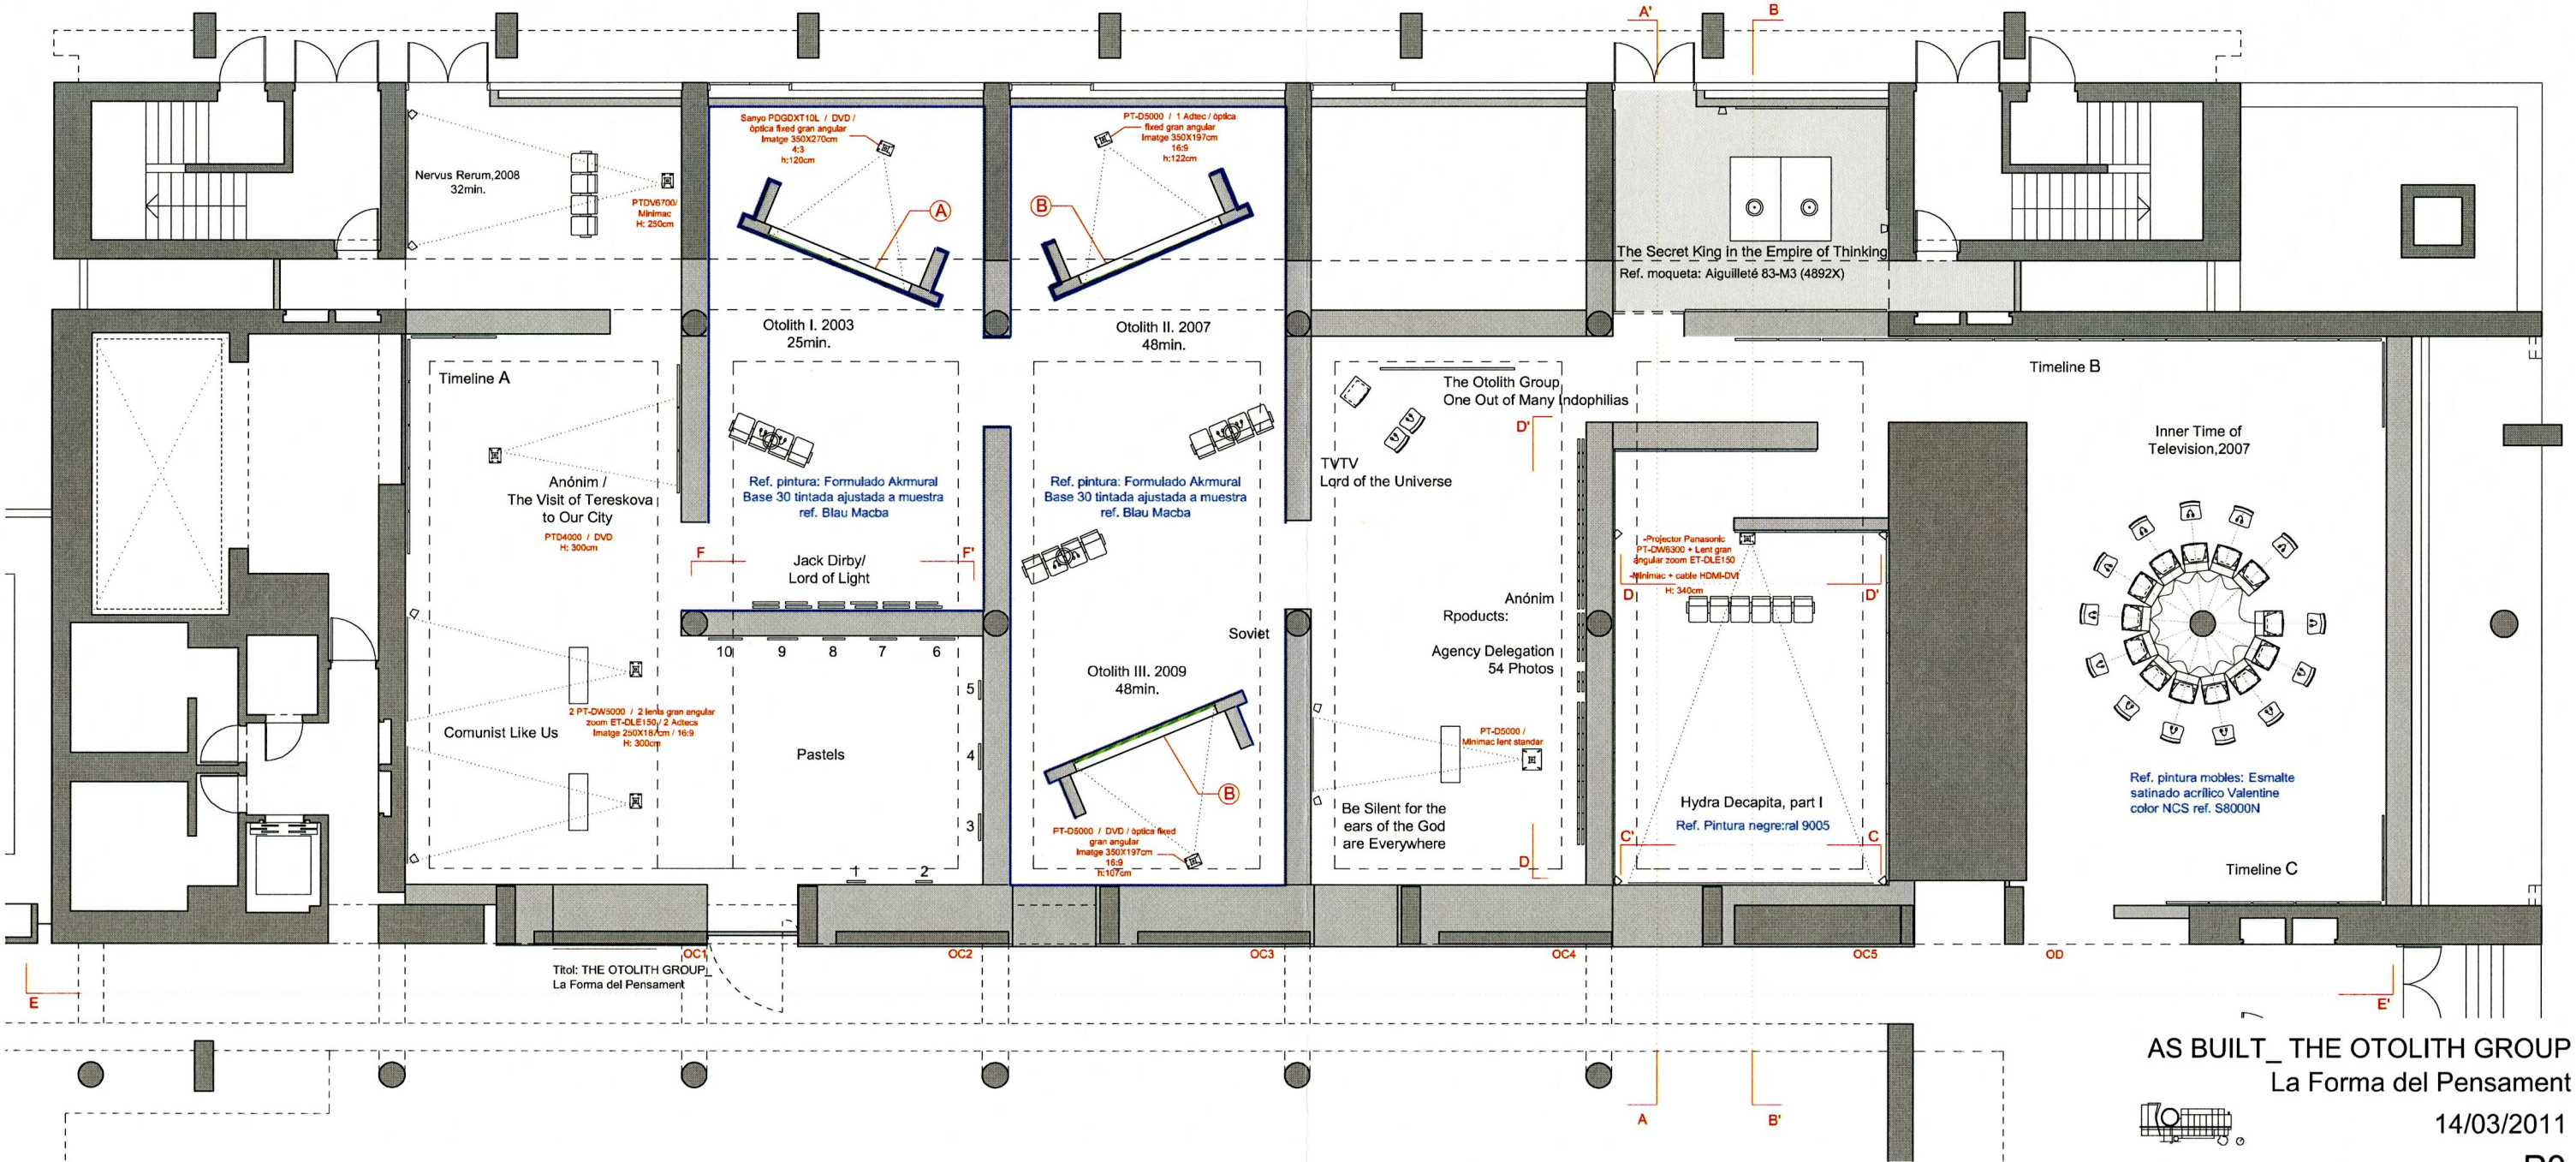

AS BUILT_ THE OTOLITH GROUP
La Forma del Pensament

14/03/2011

P0

1 5