


- 1.(*) Speakers Soundtube RS590i
- 2.(*) Speakers Soundtube RS590i
- 3.Projector Panasonic PT-DW6300 + Lent gran angular zoom ET-DLE150 / Minimac + cable HDMI-DVI
- 4.Panell acústic rigid una cara clipsado con paneles. Texaa Stereo MR 490 NOIR
- 5.(*) Subwoofer Soundtube CM1001d
- 6.Panell acústic rigid una cara clipsado con paneles. Texaa Stereo MR 820 GRIS PERLE

- 7.Ref. moqueta: Aiguilleté 83-M3 (4892X)
- 8.Altaveu sostre: Soundtube/ RS4-EZ
- 9.Altaveu terra: Soundtube/ SM500I-WH

*Minimac / Soundcard Audio / Equalitzador Alesis / Crossover / Etapa Crest

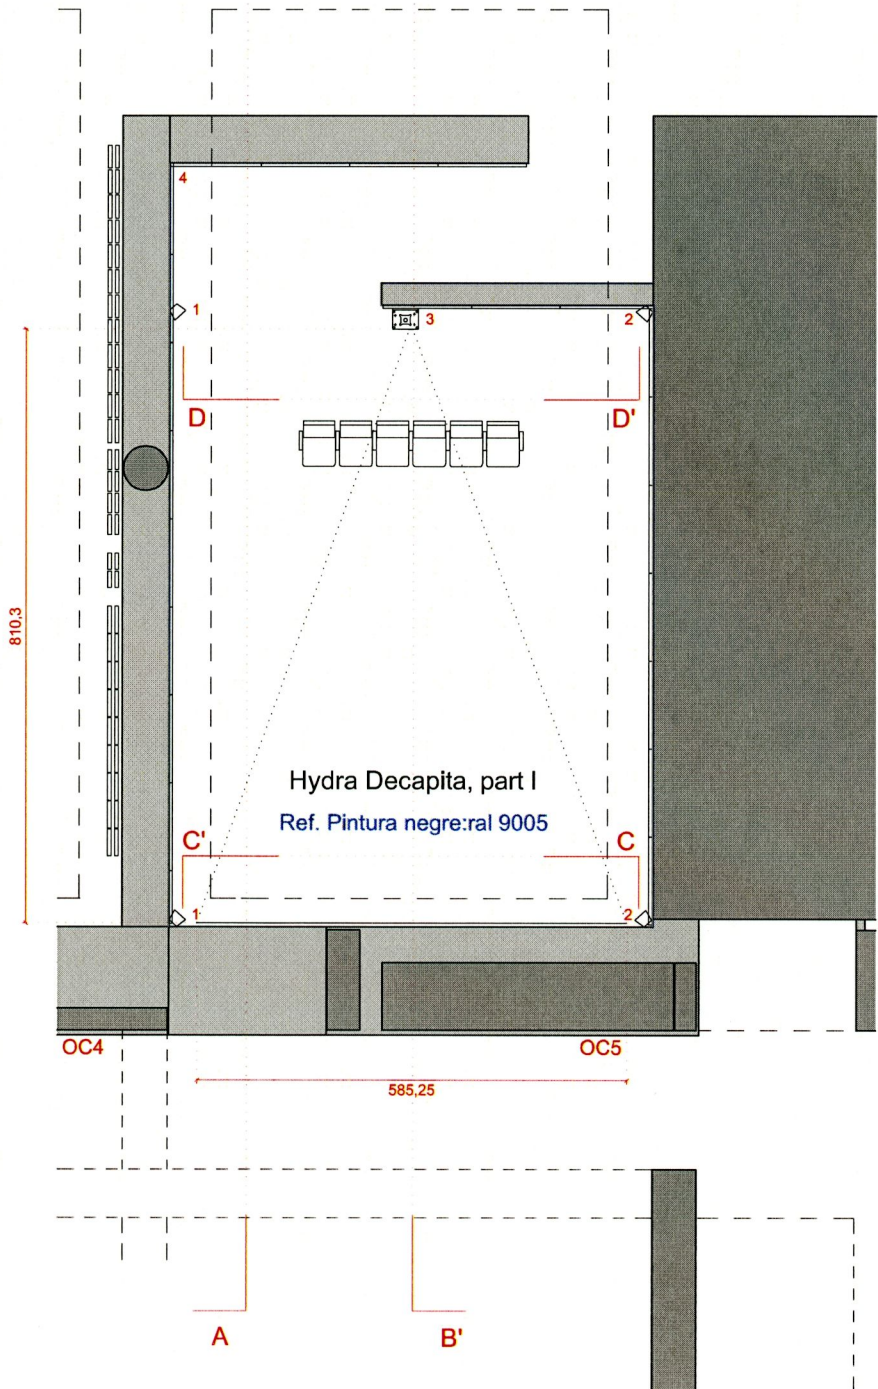

AS BUILT_ THE OTOLITH GROUP
La Forma del Pensament

14/03/2011

P0