




Takis lighting his signal... 1957

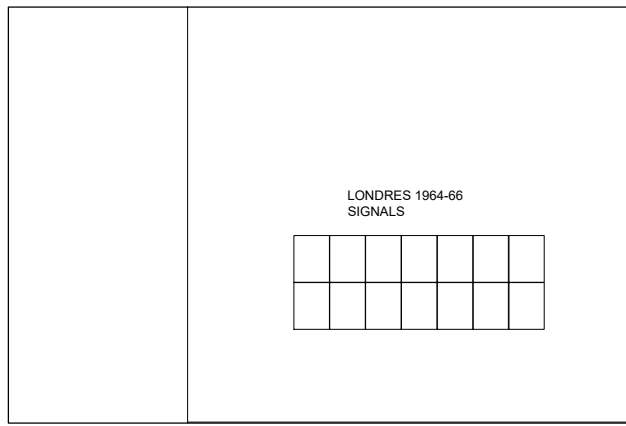


Signale vol I num 3-4

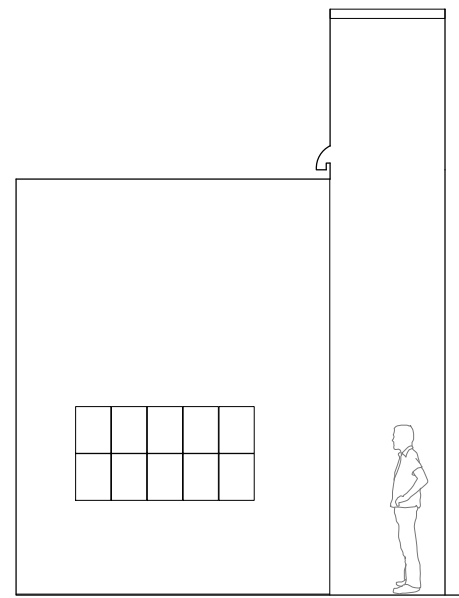


CAPILLA 1 E:1/8

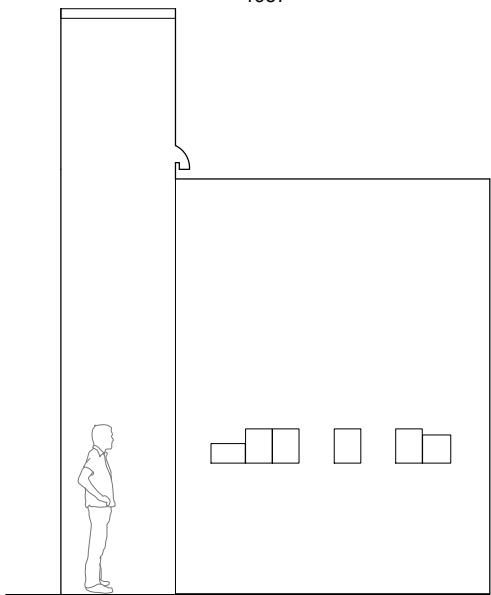

Carta dedicada a Takis de Marcel Dunchamp 1968

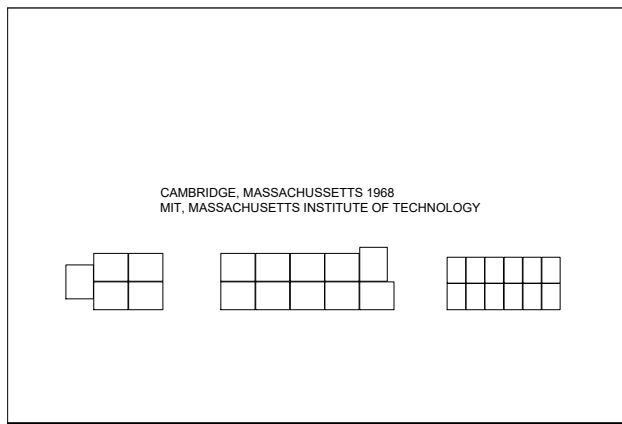


Takis Studio at MIT Exhibition at Hayden Gallery (MIT) Takis dialogues diagrams and sketches

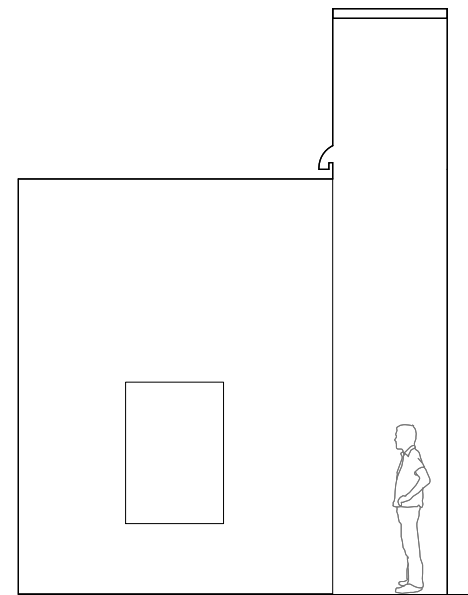


Takis working in his studio


CAPILLA 3 E:1/8

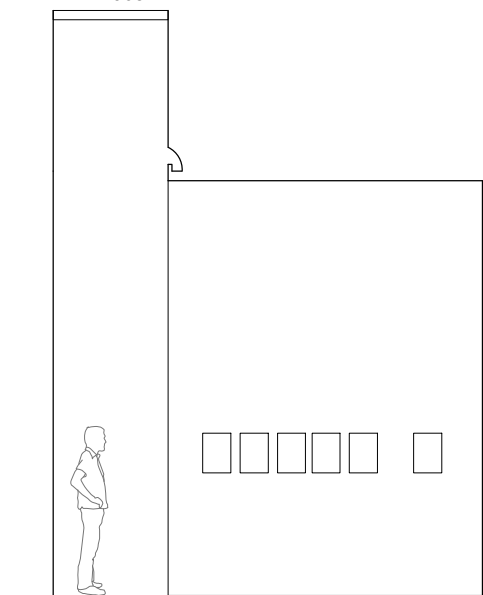

Manifestos Art Workers Coalition 1957


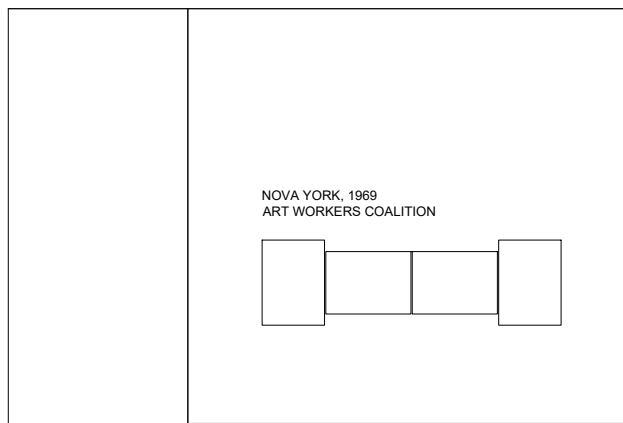


Acció de Takis a l'exposició The machine as seen at the End of the Mechanical Age 1968

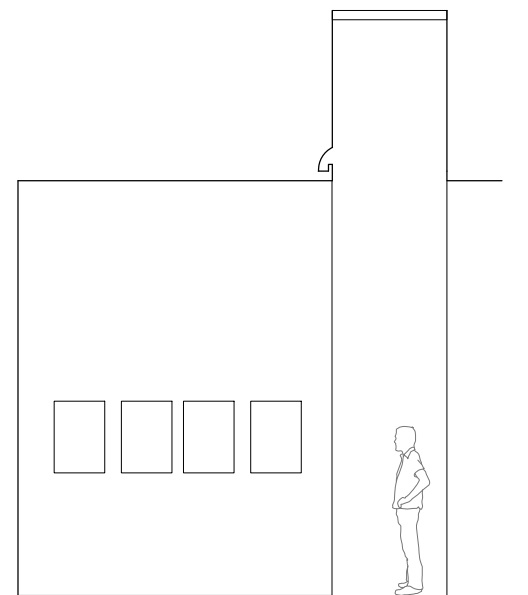

Robho (núm 1,2,5-6) 1957

CAPILLA 5 E:1/8

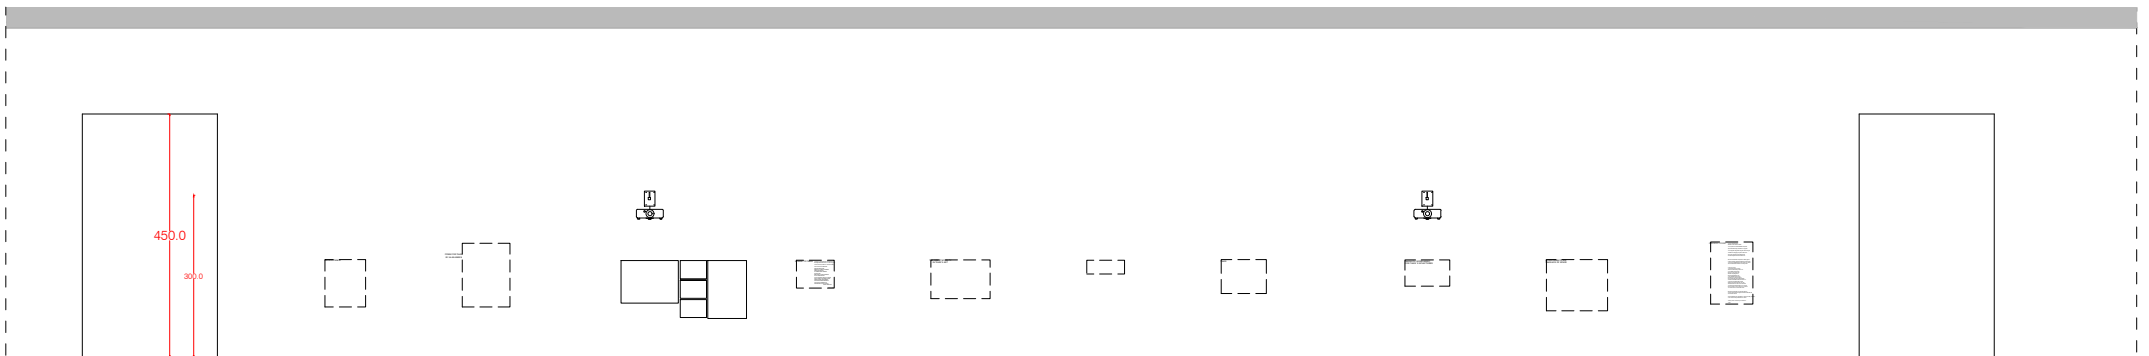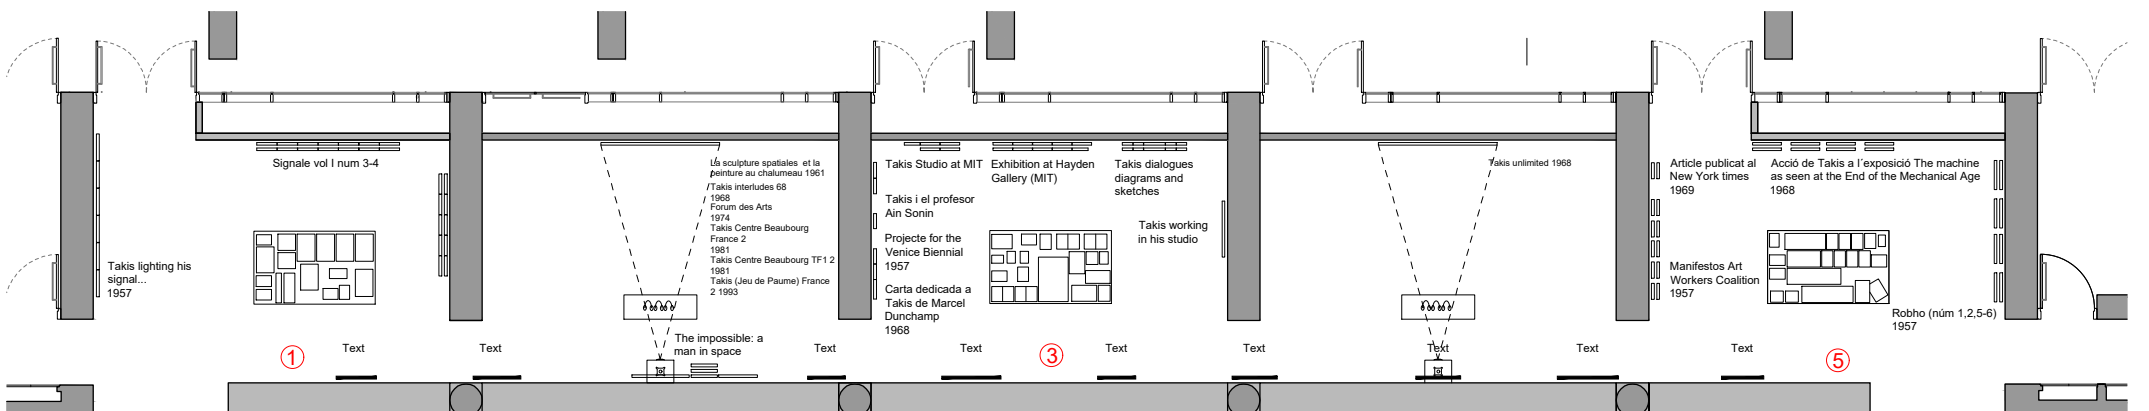

Jean Jacqueslebel Malexistence 1957

Alan Ansen Poem for TAKIS 1957

The impossible: a man in space 1960

David medalla Stele to TAKIS 1961

Alain Jouffrey the great novelty in Takis Art 1961

Allen ginsberg - 1962

William burroughs TAKIS 1962

Brion gysin Magnetic Word music -

Sinclair belles Gysin permutates/Takis ace of space 1964

Purple subway ride Gregory corso 1967

Robho (núm 1,2,5-6) 1957

ALZADO D E:1/14

440.0 720.0 720.0 720.0 440.0

0 2 5 (m)

AS BUILT-TAKIS- Capelles P0

27/01/2020

MUSEU D'ART CONTEMPORANI DE BARCELONA . M A C B A . P0