


Flower of the desert, Electronic Flower, Standing woman, Inner Space, Sphinx, locasta, Yellow Electron, Ligne parallele vibrative, Systeme de radar magnetique, Magnetron, Electro-magnetic, Magnetron, Telesculpture, Defying Gravity, Magnetron, The Never Stable Vertical line h: 59 cm, Magnetic Walls Flying fields, Telumiere 5, Telumiere 4

ALÇAT B
E:1/10

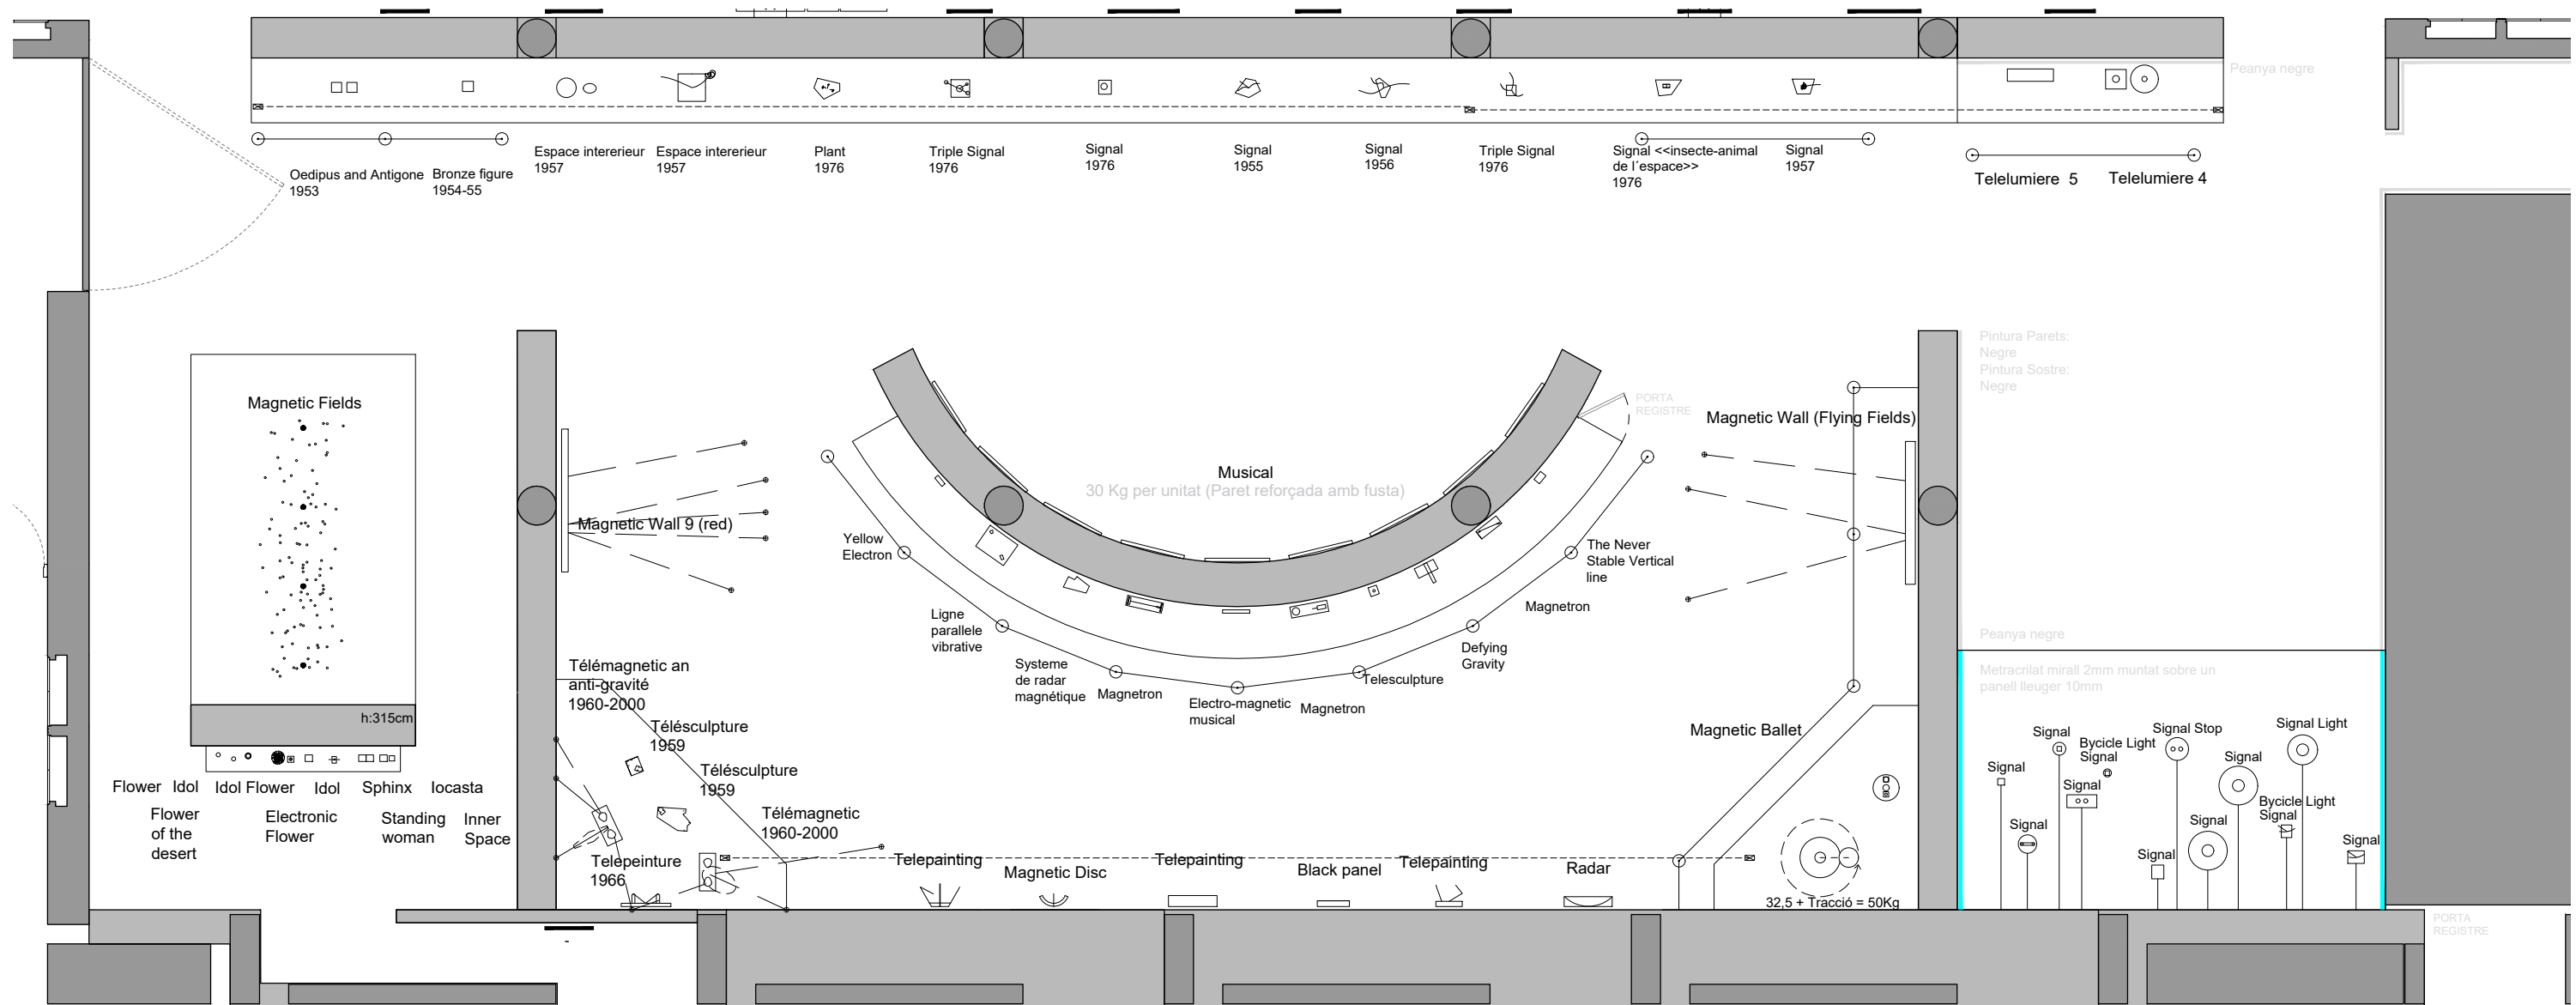

Flower of the desert, Electronic Flower, Standing woman, Inner Space, Sphinx, locasta

PLANTA SALA C
E:1/10

AS BUILT-TAKIS - Sala C
P0
27/1/2020

