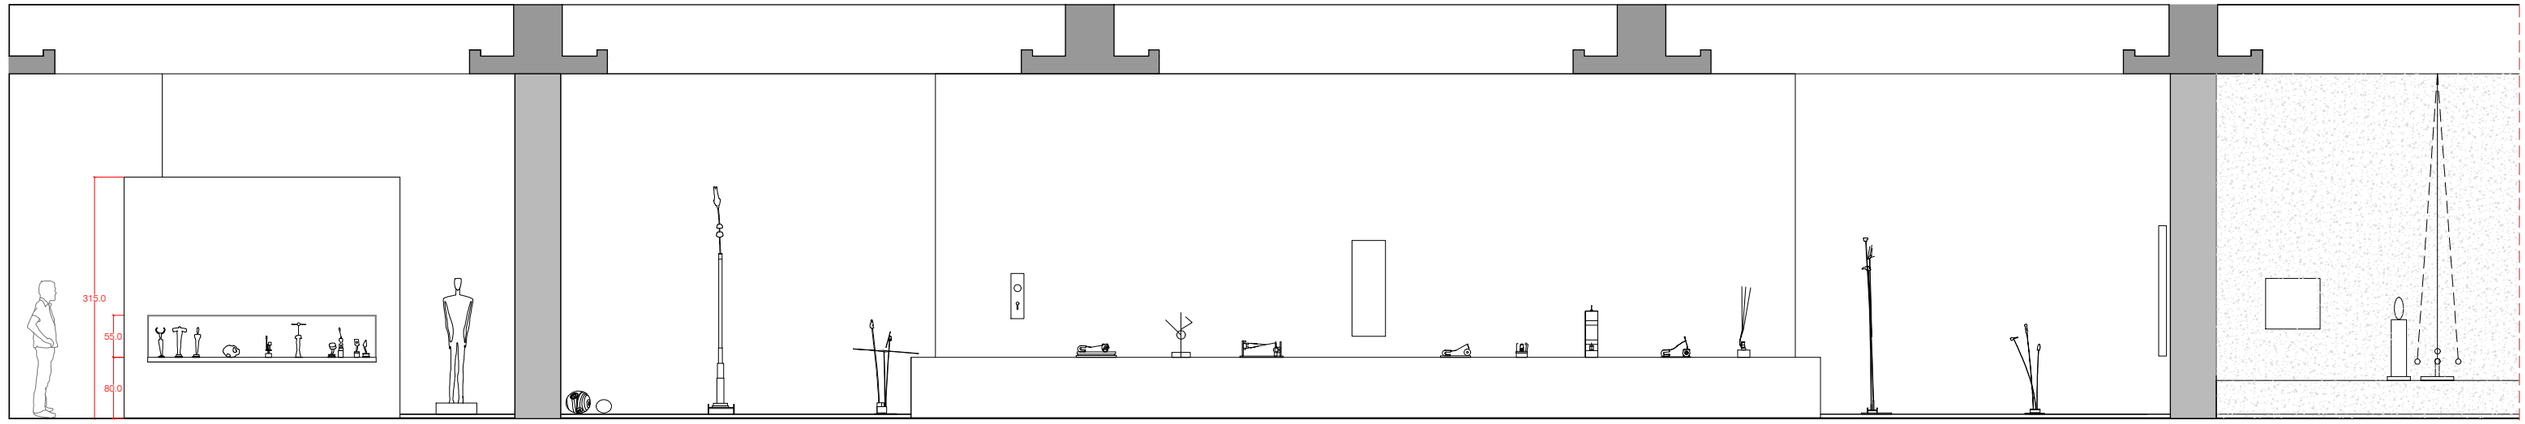

Flower of the desert
Idol
Idol Flower Electronic Flower
Idol Standing woman
Sphinx
Iocasta Inner Space
Yellow Electron
Ligne parallele vibrative
Systeme de radar magnétique
Magnetron
Electro-magnetic musical
Magnetron
Telesculpture
Defying Gravity
Magnetron
The Never Stable Vertical line h: 59 cm
Magnetic Walls Flying fields
Telelumiere 5
Telelumiere 4

ALÇAT B
E:1/8

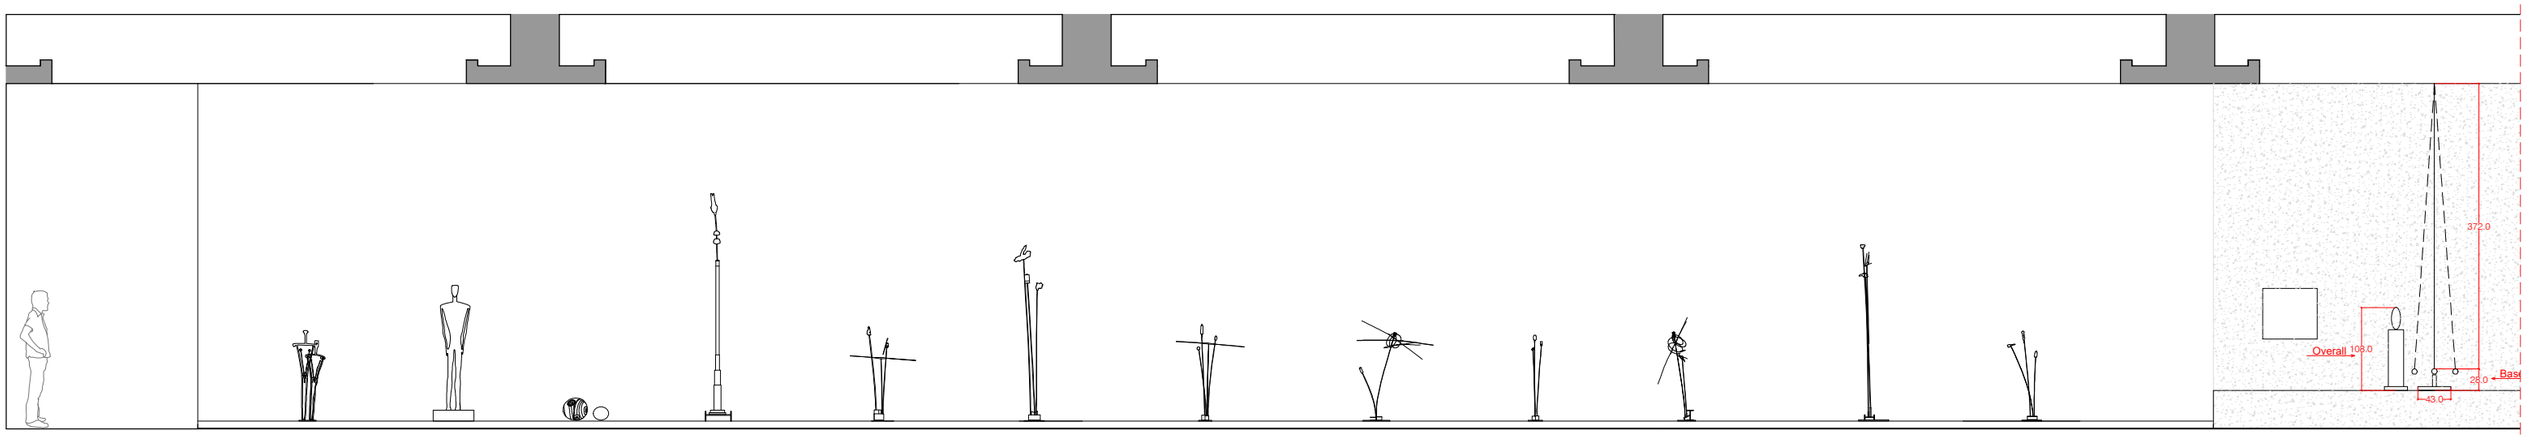

Oedipus and Antigone 1953
Bronze figure 1954-55
Espace intererieur 1957
Espace intererieur 1957
Plant 1976
Triple Signal 1976
Signal 1976
Signal 1955
Signal 1956
Triple Signal 1976
Signal <<insecte-animal de l´espace>> 1976
Signal 1957
Telelumiere 5
Telelumier 4

ALÇAT C
E:1/8

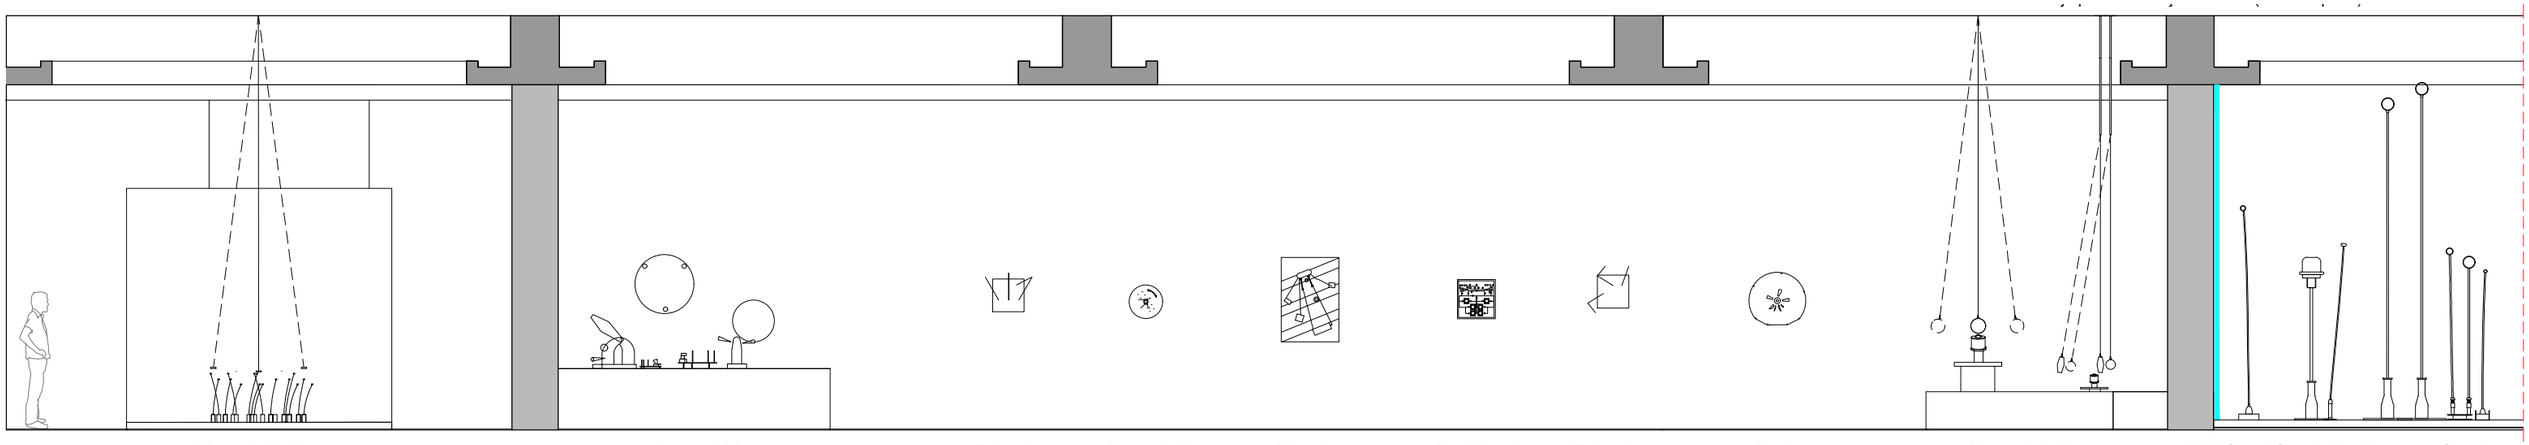

ALÇAT A
E:1/8

Magnetic Fields
Peanya NY
Telepeinture
Magnetic Disc
Telepeinture
Black Panel
Telepeinture
Radar
Magnetic Ballet
Mirall
Signal
Signal
Signal
Bycicle Light Signal
Signal stop
Signal
Signal

AS BUILT-TAKIS- Alçats
P0
27/01/2020

0 2 5 (m)